

Deer Creek Mine  
9th East Portals




Reclaimed Portals

Deer Creek Mine  
9th East Phase III  
Bond Release Area

Reclaimed AML Portals

RECLAMATION COMPLETED  
DECEMBER 1999  
0.60 ACRES

Cottonwood Mine  
Disturbed Area

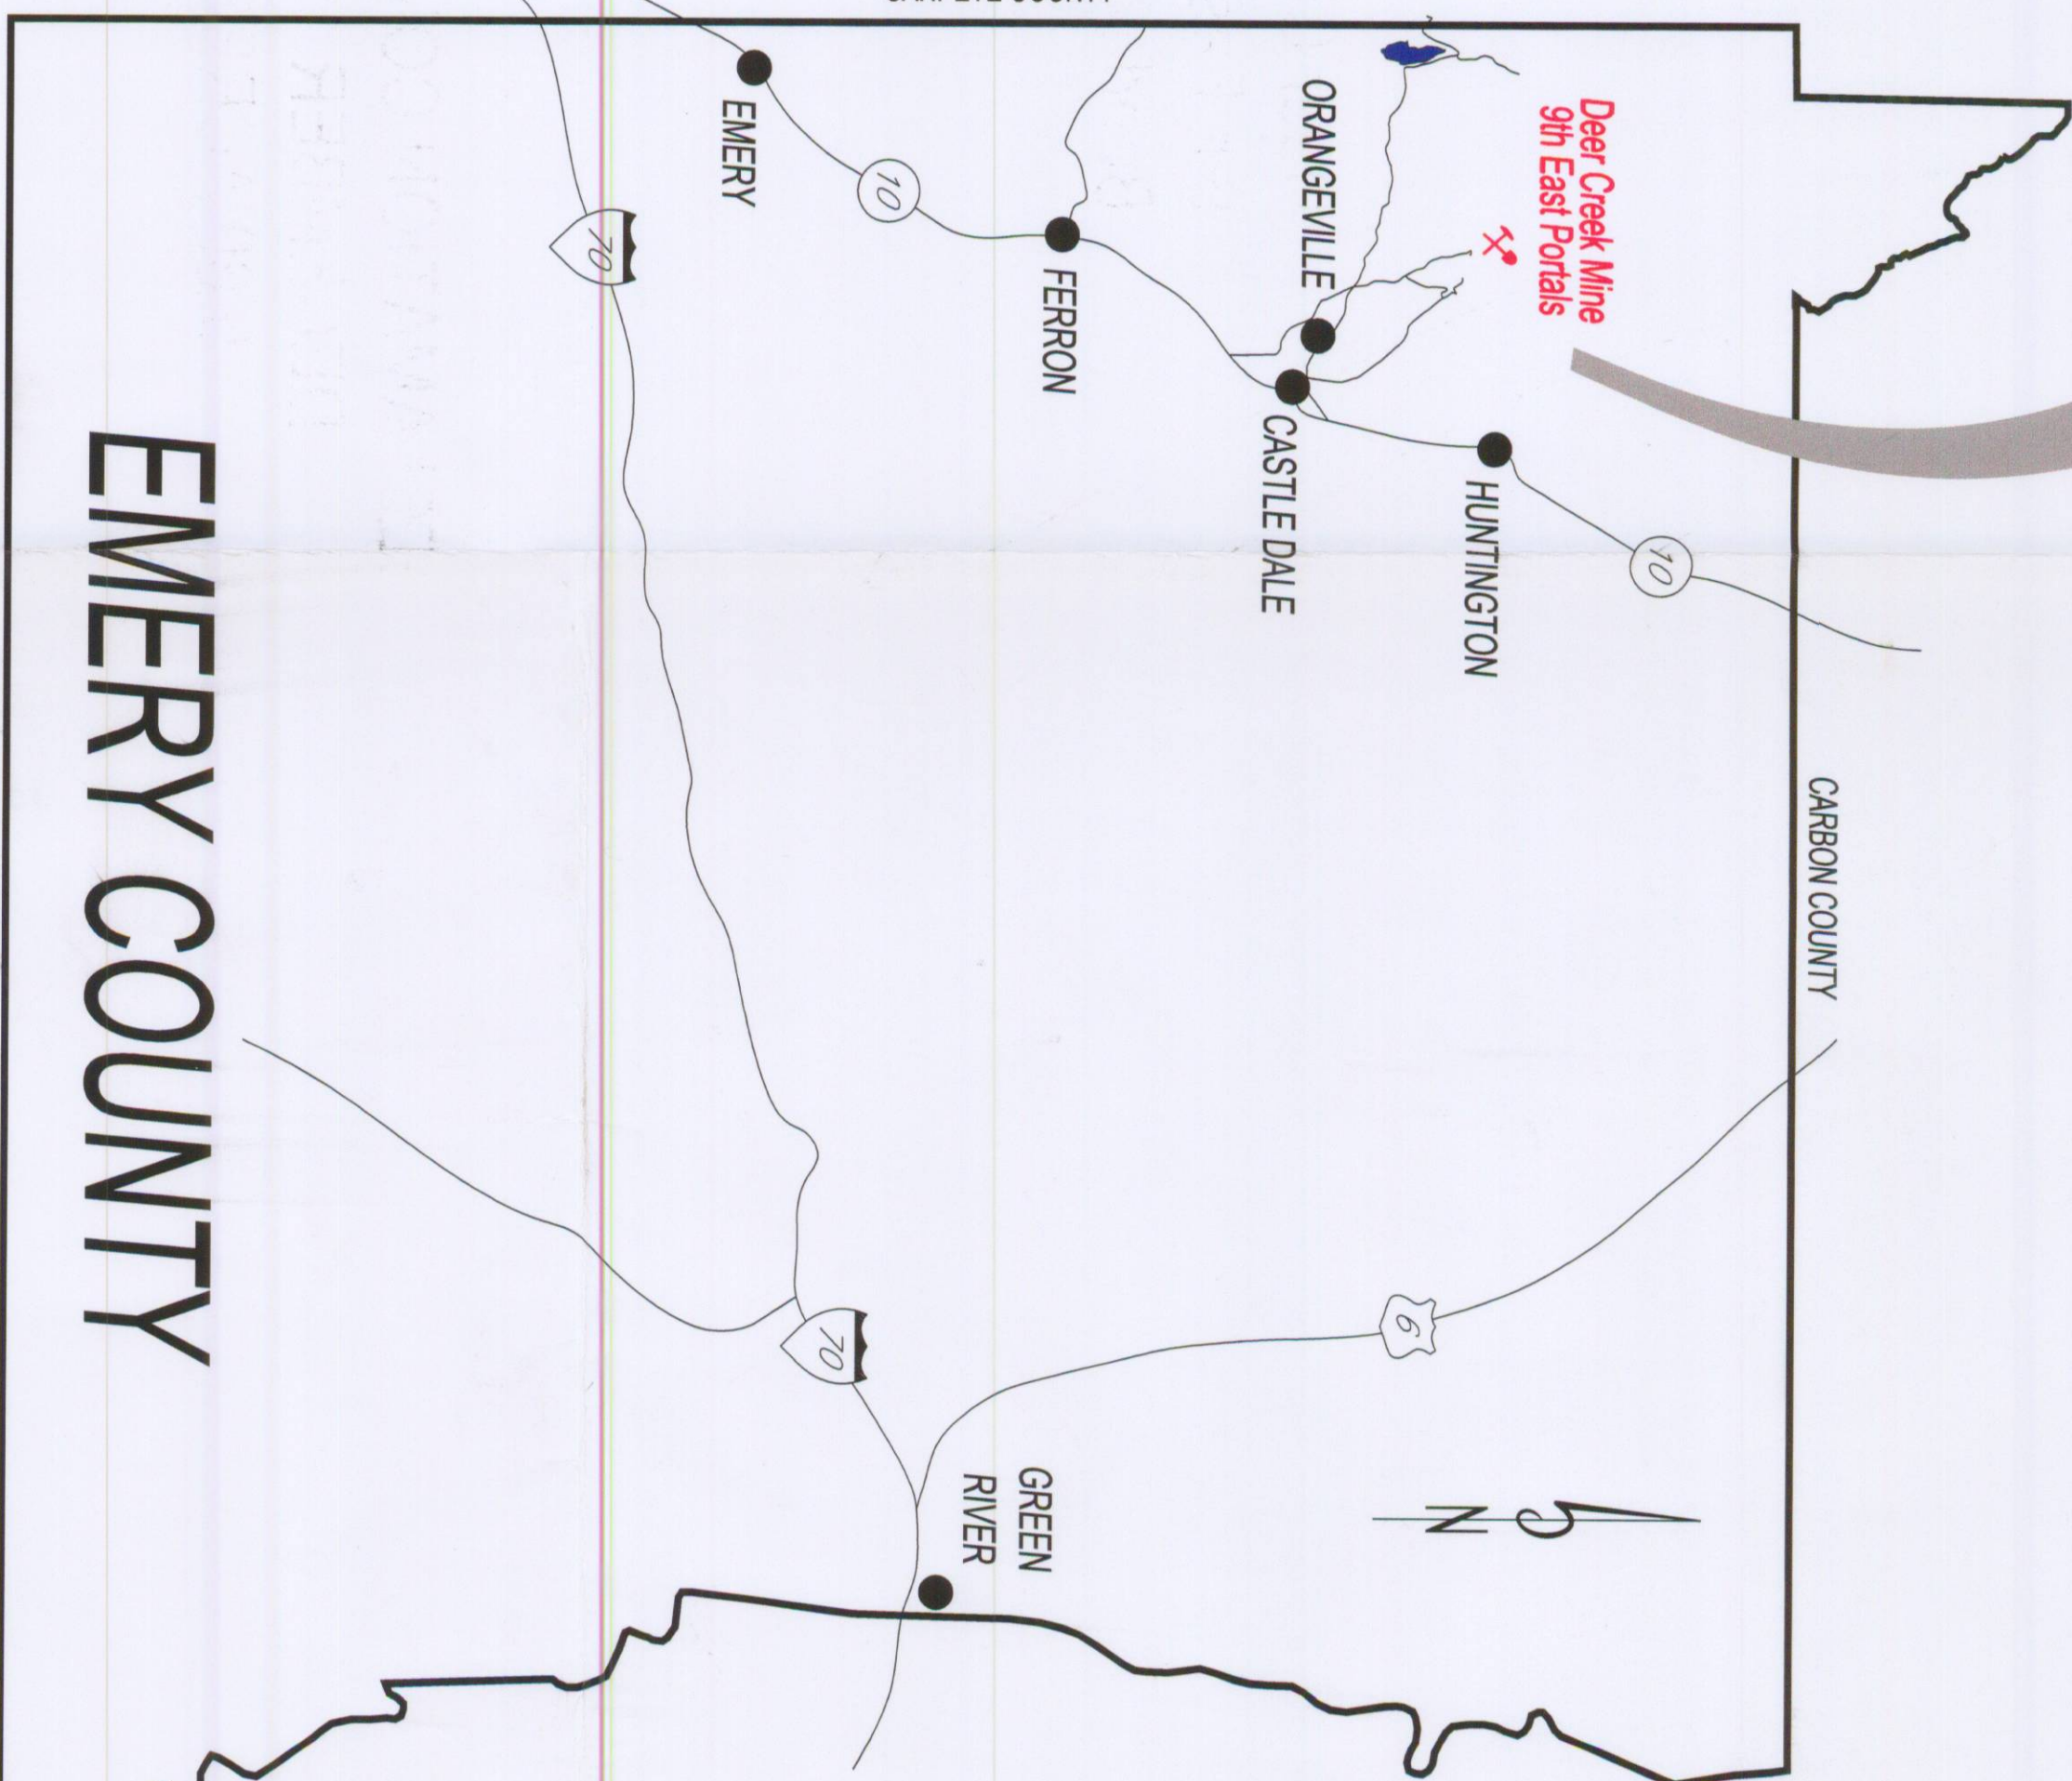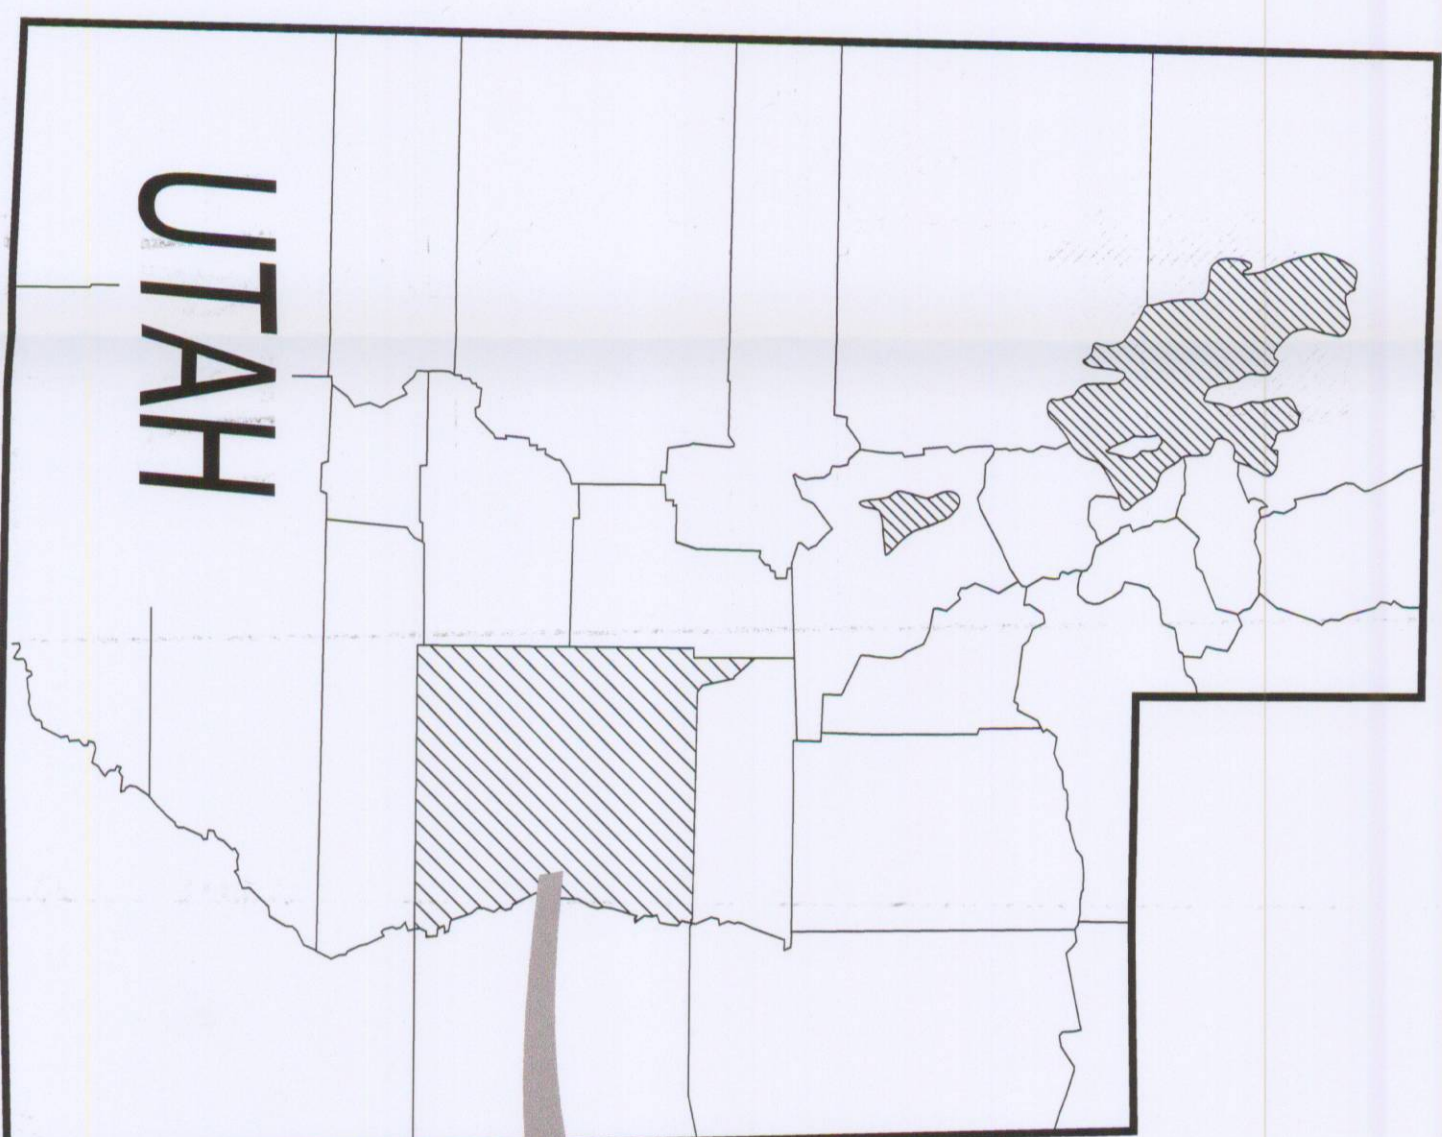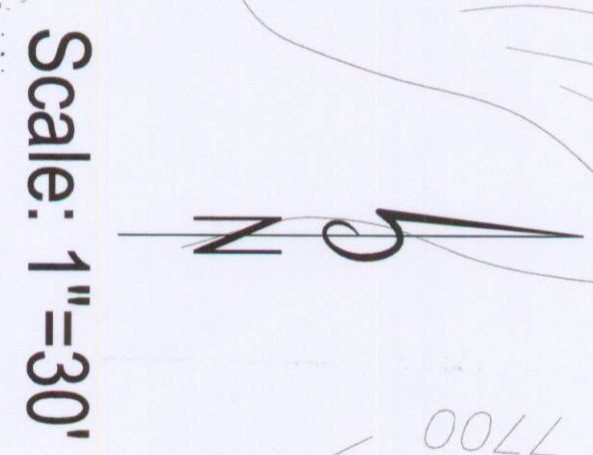

Not to Scale



DEER CREEK MINE  
9TH EAST PORTALS  
PHASE III BOND RELEASE



NOTE: THIS DRAWING REPRESENTS THE AS-BUILT CONDITION  
DIV. OF OIL, GAS & MINING

RECEIVED  
JAN 11 2011

FILE NO:	033902
DRAWN BY:	K. LARSEN
SCALE:	AS NOTED
DATE:	DECEMBER 30, 2010
SHEET:	1 OF 1
REV:	